


1  
A-00-004  
PROPOSED RENOVATION MASTER PLAN  
THIRD FLOOR PLAN  
SCALE 1:300 MTS



2  
A-00-004  
AS-BUILT PLAN  
FOURTH FLOOR PLAN  
SCALE 1:300 MTS



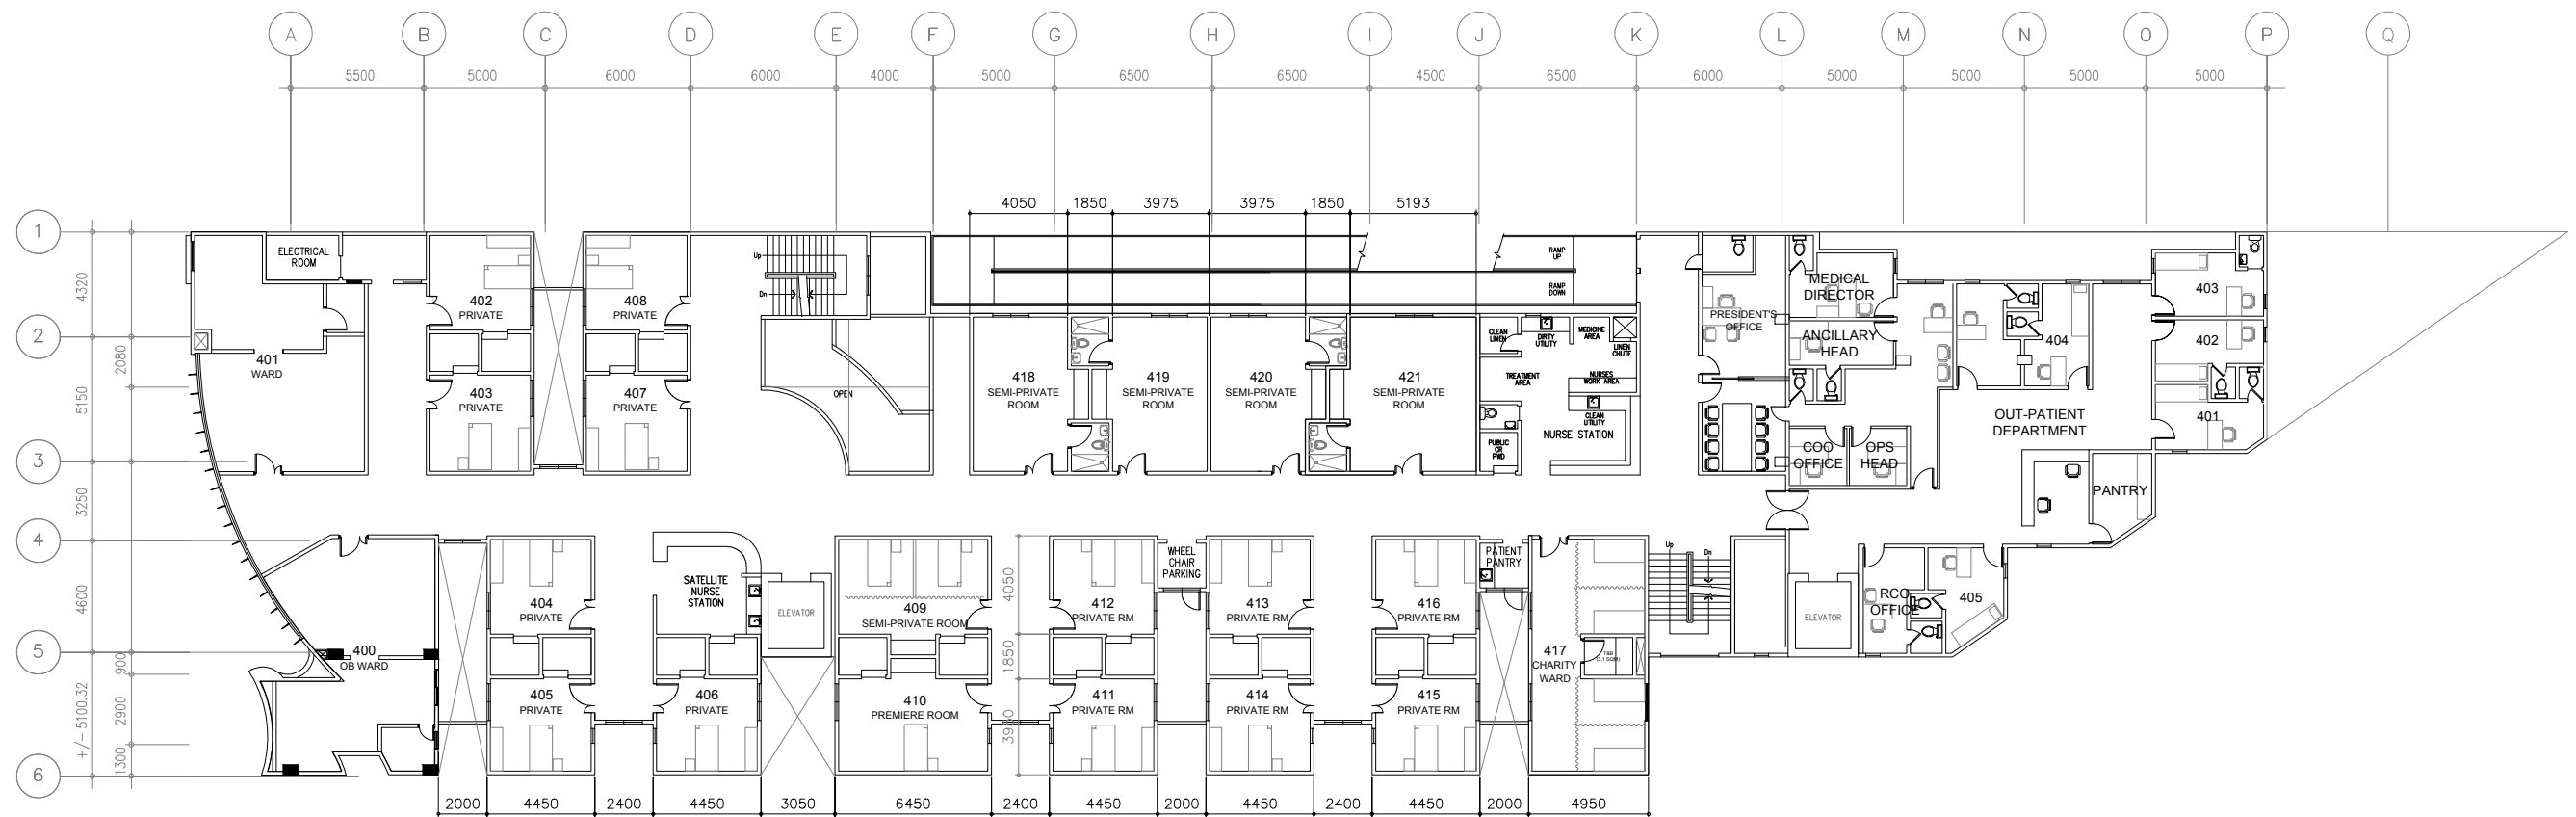